


GULF

CONTRACT NO 24069

006

017

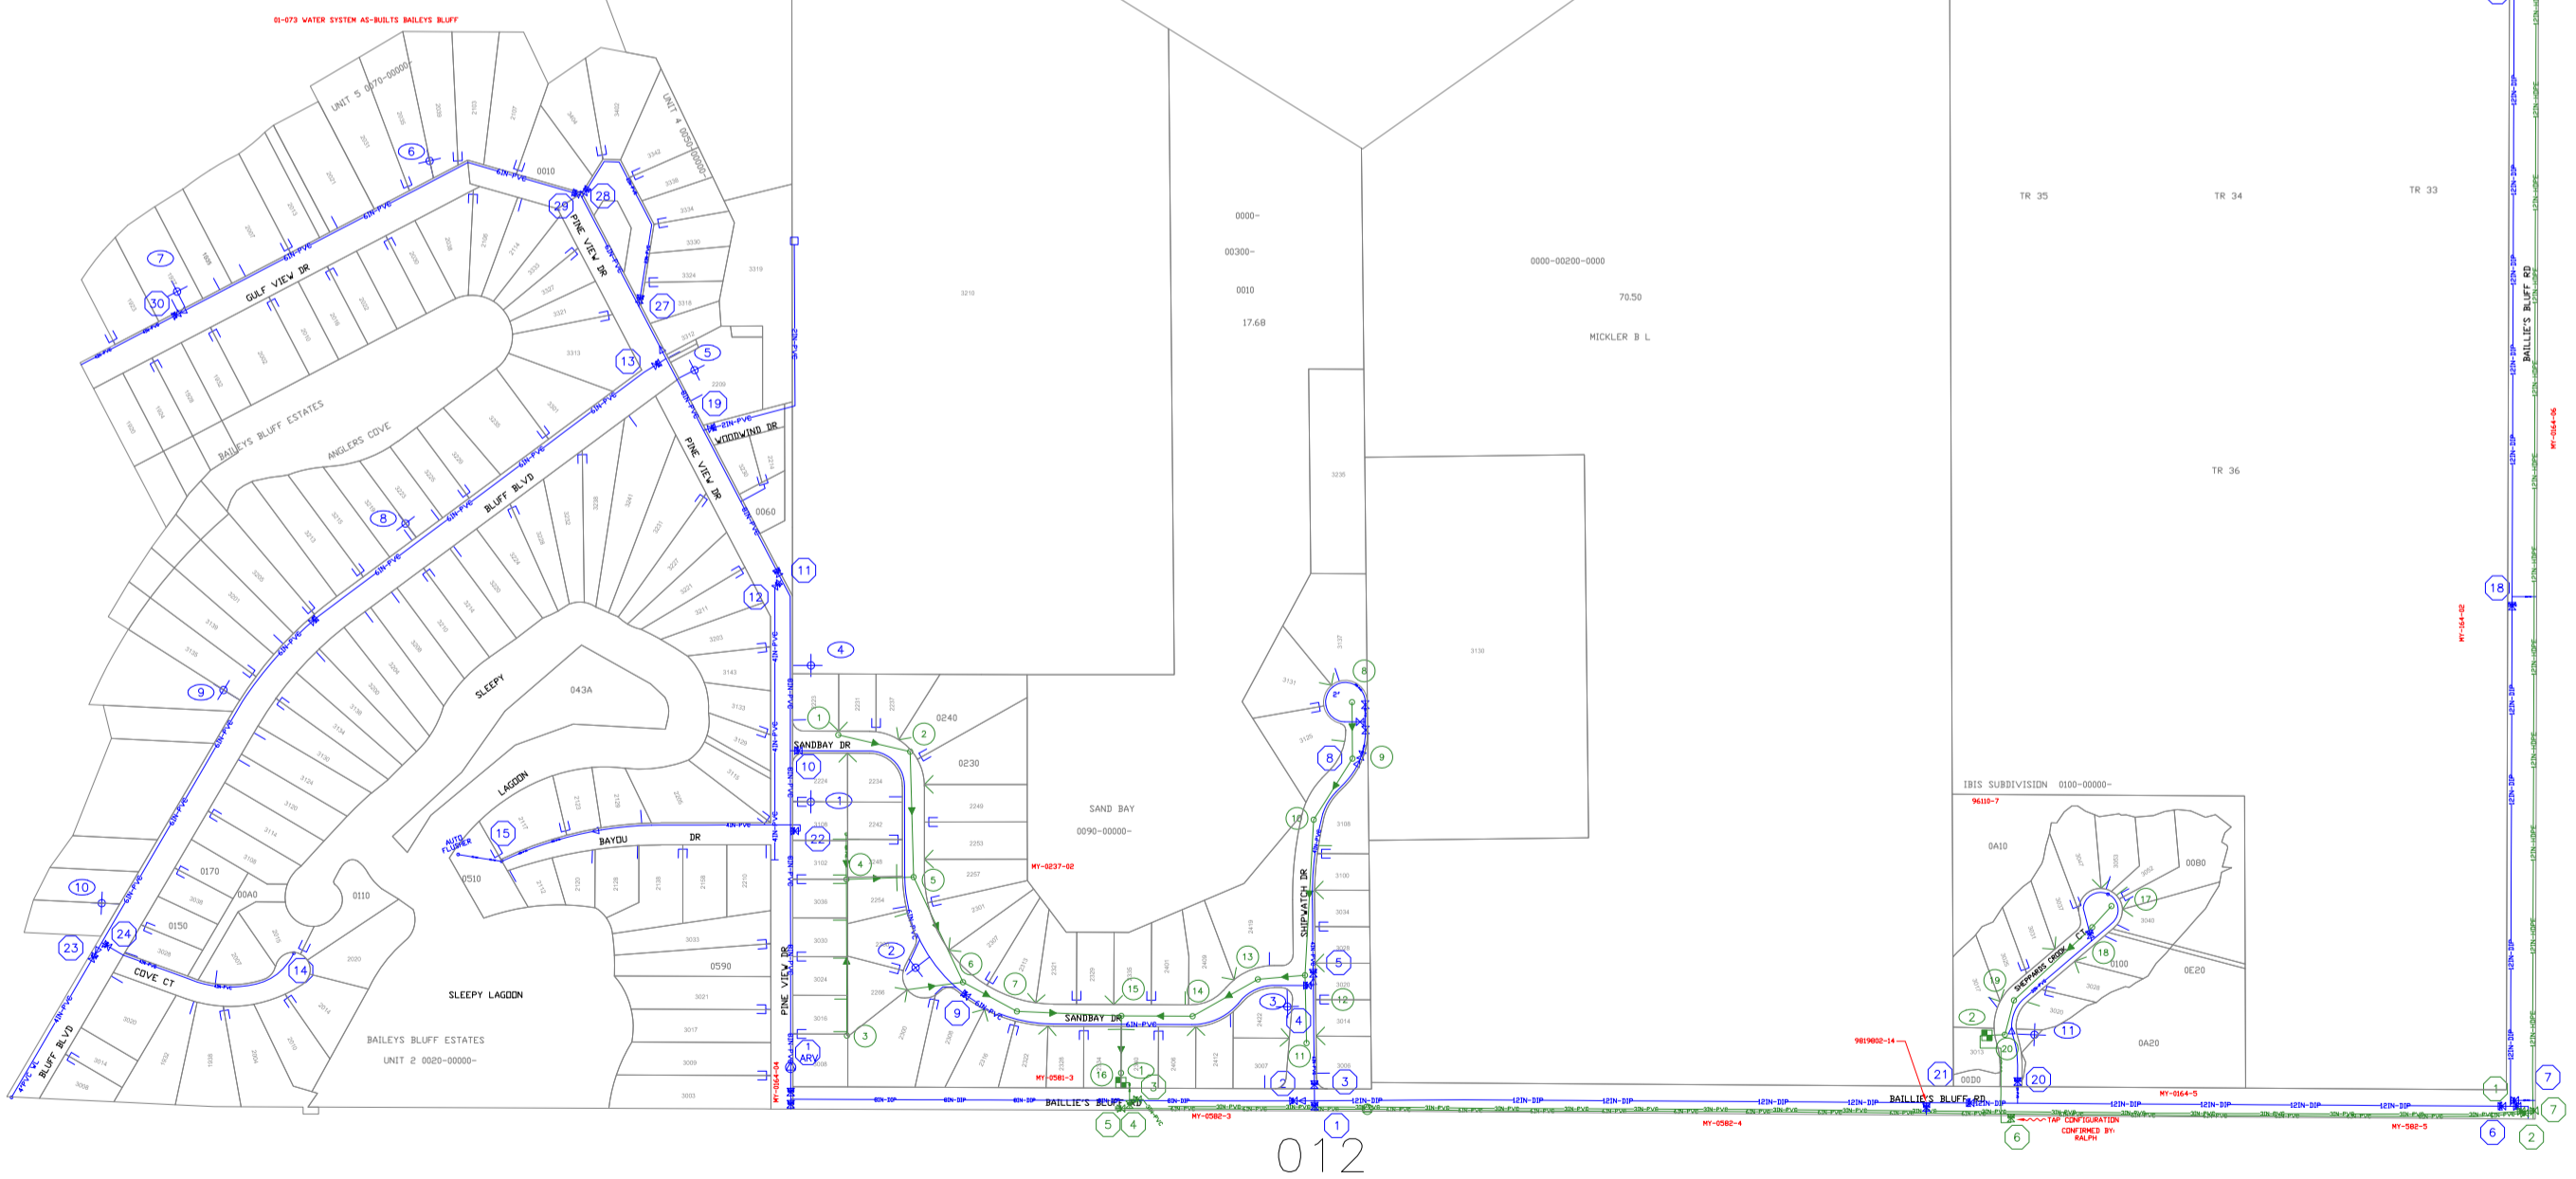

GOVERNMENT LOT 1  
0000-0400-0000  
197.86  
SHEPPARD RICHARD J &  
KATHLEEN M

TR 35 TR 34 TR 33  
TR 36

012

LEGEND

- WATER MAIN (WM)
- WELL
- FIRE HYDRANT
- FIRE HYDRANT NUMBER
- DOUBLE SERVICE WATER LATERAL
- SINGLE SERVICE LATERAL
- REDUCER
- GATE VALVE
- METER
- ABANDONED MAIN WM, SM, FM, RM
- PRIVATE UTILITY WATER MAIN
- P.S.R. = PRIVATE SITE RESTORATION
- N.C.M. = NOT COUNTY MAINTAINED
- SEWER GRAVITY MAIN (SM)
- FORCE MAIN (FM)
- SEWER MANHOLE NUMBER
- SEWER GRAVITY SERVICE LATERAL
- SEWER GRAVITY SERVICE LATERAL
- LIFT/PUMP STATION NUMBER (L/S/PS)
- LIFT/PUMP STATION (L/S/PS)
- PRIVATE UTILITY SERVICE AREA
- PRIVATE UTILITY SEWER GRAVITY MAIN
- PRIVATE UTILITY FORCE MAIN
- RECLAIMED MAIN (RM)
- DOUBLE RECLAIMED SERVICE LATERAL
- SINGLE RECLAIMED SERVICE LATERAL
- BACK FLOW PREVENTER OR CHECK VALVE
- BLOW-OFF OR CLEAN OUT
- AIR RELEASE VALVE
- AIR RELEASE VALVE NUMBER
- VALVE NUMBER
- PRIVATE UTILITY RECLAIMED MAIN
- NOTE: ALL SEWER GRAVITY MAIN, 8" PVC UNLESS NOTED OTHERWISE.

PASCO COUNTY UTILITIES SYSTEM

MAP CONTENTS

01-073 WATER SYSTEM ASBUILTS BAILEYS BLUFF	.	.
MY-0237-SANDBAY	.	.
MY-0581-SANDBAY	.	.
MY-0582-STRAUBER MEMORIAL DR	.	.
MY-0164-BAILEYS BLUFF WATERMAIN EXT	.	.
PCU-96110-IBIS SUBDIVISION	.	.
.	.	.
.	.	.
Prepared by Pasco County Utilities Department

This map is provided for information purposes only, and is not intended to be a commitment that utilities services are available. This map is a sketch only, and should not be relied on for design purposes.

WATER ATLAS MAP  
SEWER ATLAS MAP  
RECLAIMED ATLAS MAP

ACAD FILE:	DRAWN BY:	DATE:
MAP011.dwg	09/28/25/28	7/30/2020
SEC.	TWN.	RNG.
23	26	15

SCALE: 1"= 200' / 1"= 400'

011